
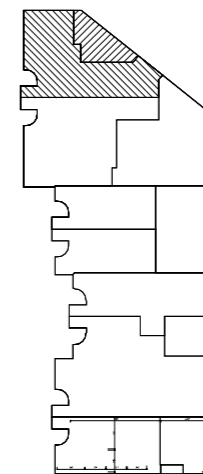


○ IN HOME HEALTH LLC - SUITE #17

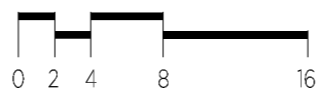

ENERGY PARK PLAZA TECH

1400 ENERGY PARK DRIVE

ST. PAUL, MN 55108

OFFICE: 2,400 RSF

WAREHOUSE: 622 RSF

TOTAL: 3,022 RSF

03/17/15